


1410 Monument Blvd. | Concord, CA

 [View Virtual Tour](#)

Building One | First Floor

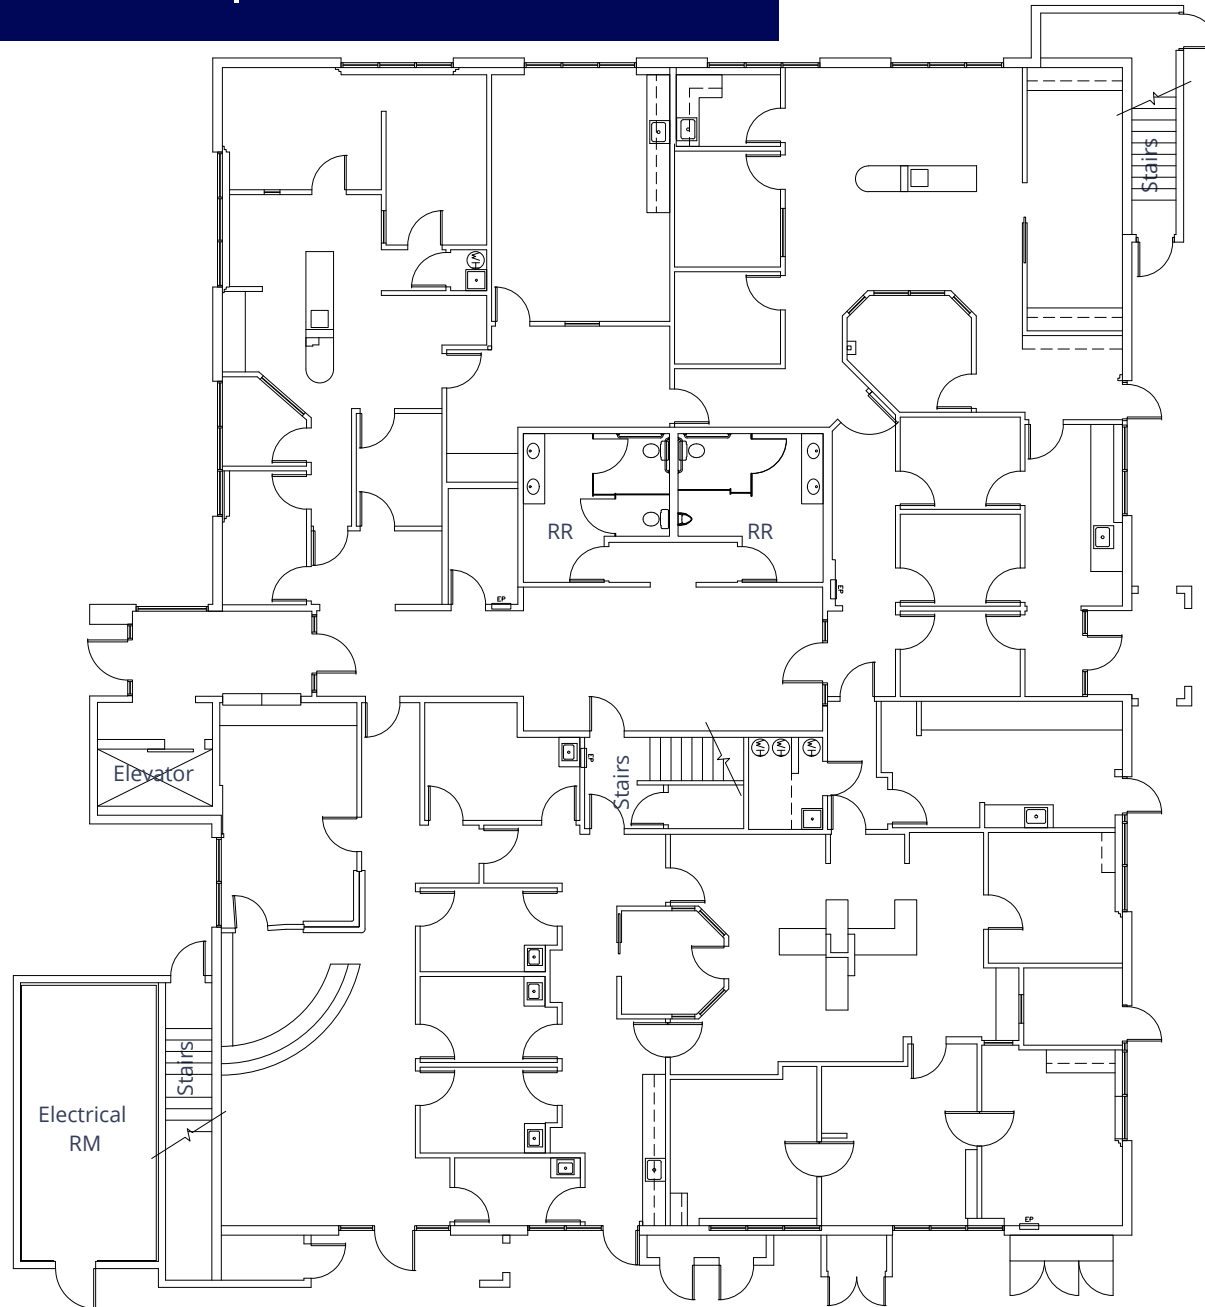


**Plan not to scale*

1410 Monument Blvd. | Concord, CA

 [View Virtual Tour](#)

Building One | Second Floor


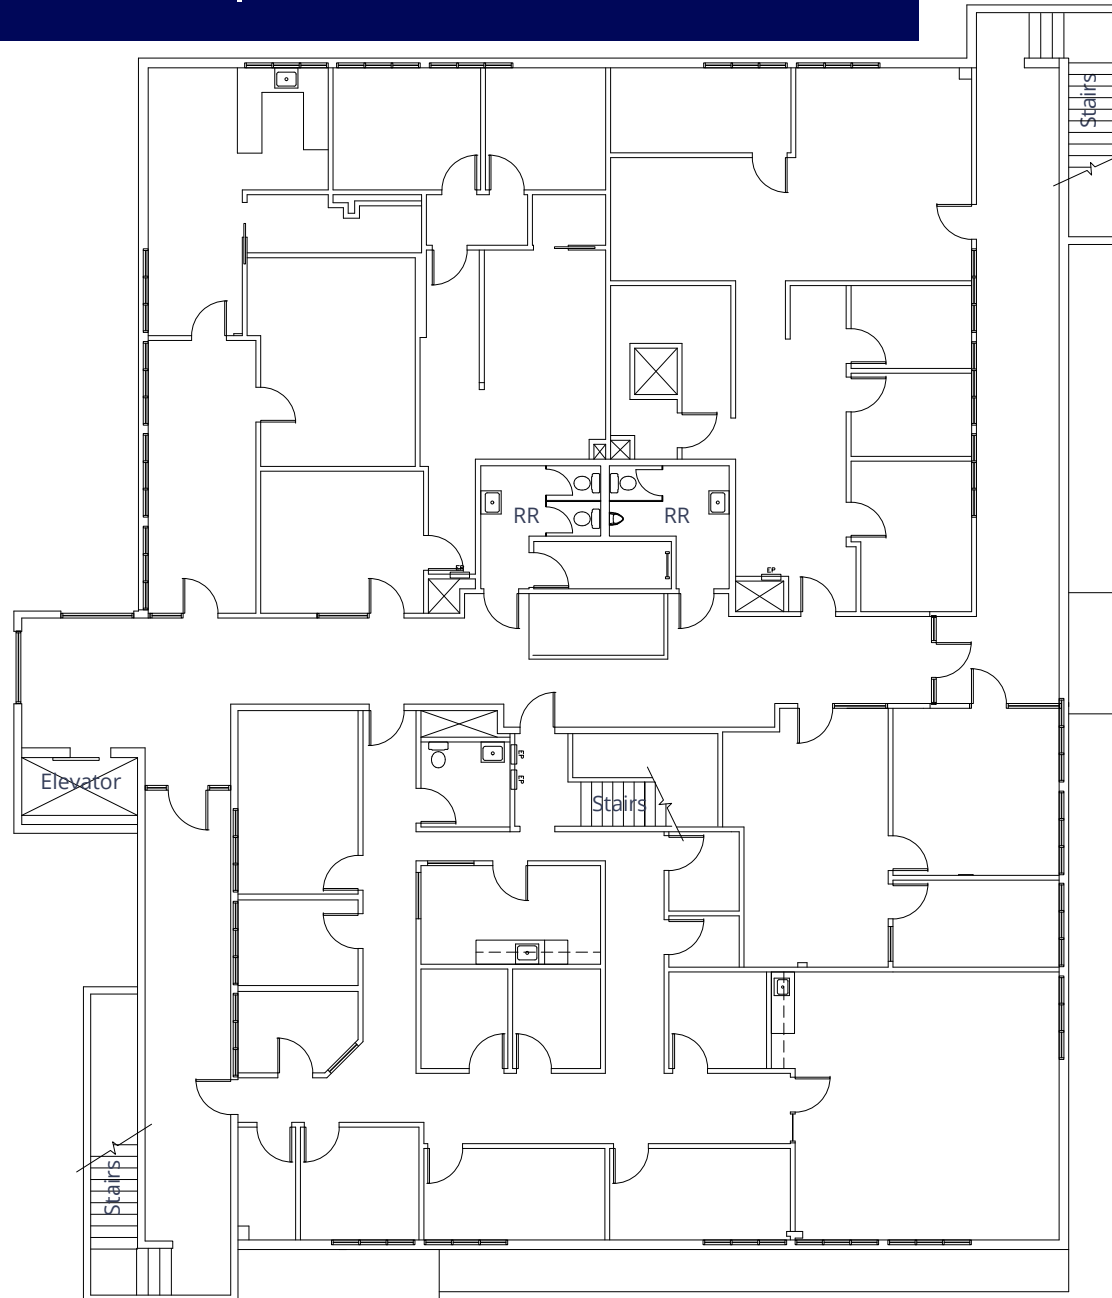


**Plan not to scale*

1410 Monument Blvd. | Concord, CA

 [View Virtual Tour](#)

Building Two | As Built Plan

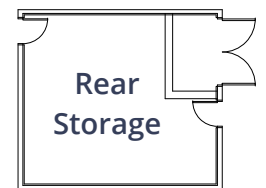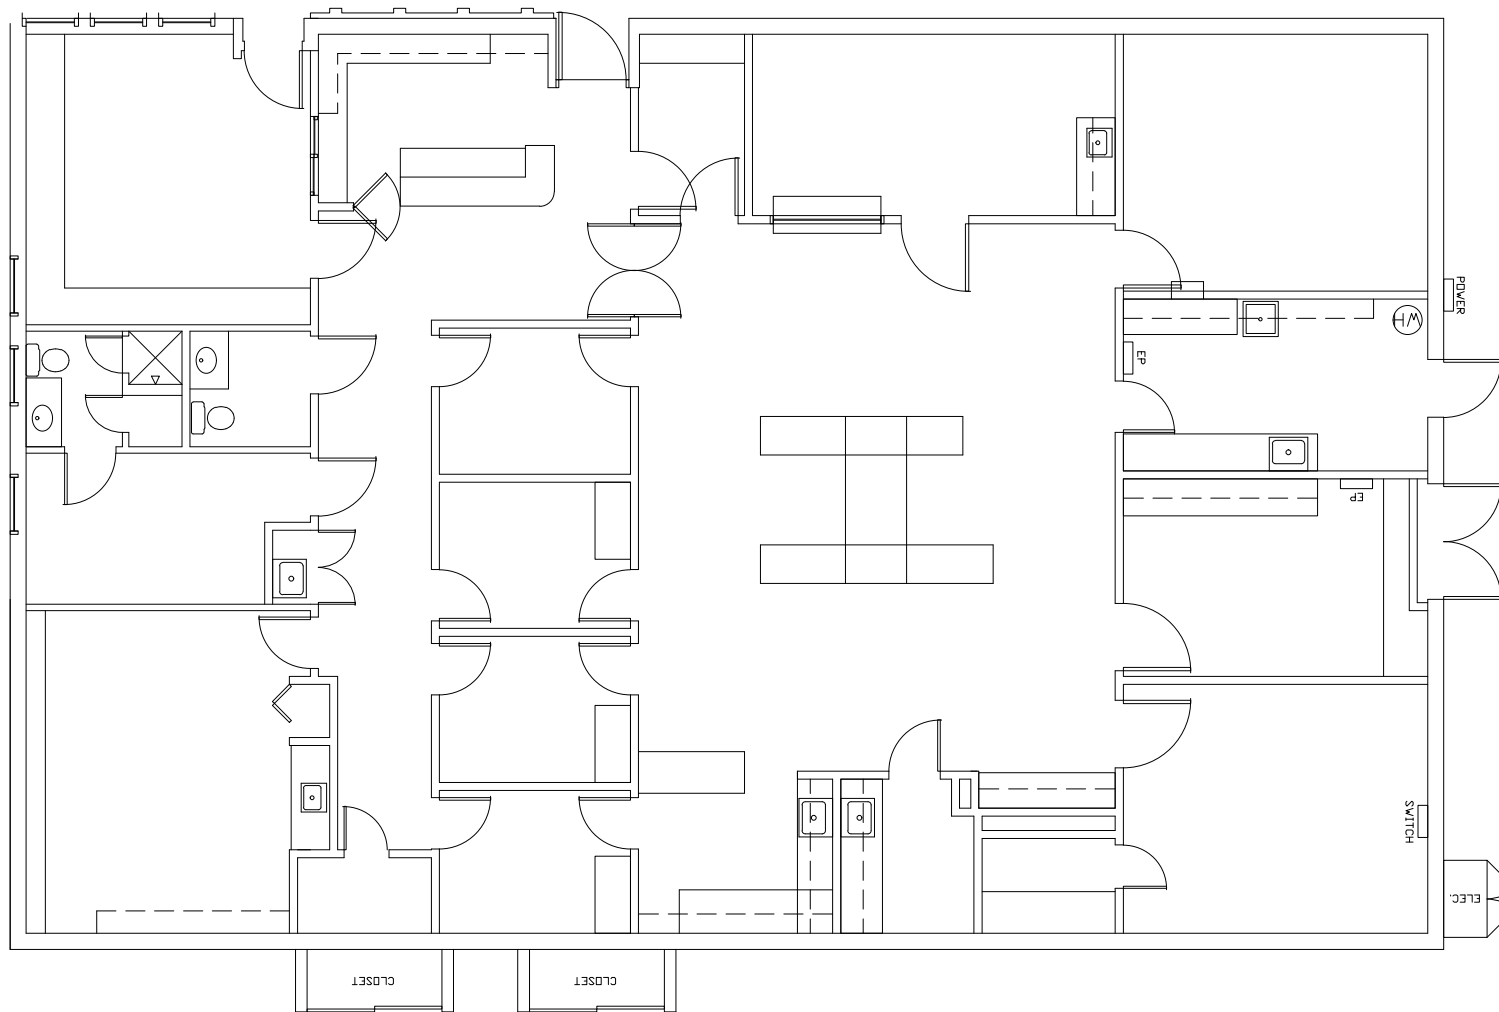

**Plan not to scale*